


RETAINED TREES

LOT #	TAG #	SPECIES/DBH	HEIGHT	SURREY PROTECTION ZONE	COMMENTS
3	384	Douglas Fir/96cm	4.3m	5.80m Radius	Remove Ivy
3	1032	Douglas Fir/76cm	32m	4.50m Radius	Remove Ivy
4	378	Douglas Fir/59cm	26m	3.60m Radius	Requires Arbarist Supervision
4	1016	Douglas Fir/83cm	27m	3.80m Radius	
Neighbour South	390	Poplar/46cm	21m	2.70m Radius	
	381			4.80m Radius	
City	1030	Douglas Fir/78cm	39m	4.70m Radius	
City	383	Douglas Fir/63cm	36m	3.80m Radius	
City	1925	Douglas Fir/72cm	36m	4.40m Radius	
City	386	Douglas Fir/58cm	22m	3.50m Radius	
City	1927	Douglas Fir/48cm	8m	2.90m Radius	
City	1928	Douglas Fir/77cm	33m	4.60m Radius	
City	A	Douglas Fir/12cm	8m	1.00m Radius	
City	B	Douglas Fir/27cm	15m	1.70m Radius	
City	1929	Douglas Fir/89cm	37m	5.00m Radius	
City	C	Douglas Fir/7cm	5m	1.00m Radius	
City	D	Douglas Fir/10cm	7m	1.00m Radius	
City	E	Douglas Fir/17cm	10m	1.00m Radius	
City	1930	Douglas Fir/48cm	27m	2.80m Radius	
City	F	Douglas Fir/18cm	10m	1.10m Radius	
City	G	Douglas Fir/16cm	10m	1.00m Radius	
City	1932	Douglas Fir/117cm	38m	6.40m Radius	
City	1933	Douglas Fir/99cm	37m	6.00m Radius	
City	H	Douglas Fir/8cm	5m	1.00m Radius	
City	I	Douglas Fir/8cm	6m	1.00m Radius	
City	1934	Douglas Fir/94cm	20m	5.40m Radius	
City	1935	Douglas Fir/51cm	25m	3.00m Radius	
City	1036	Douglas Fir/48,31	24m	4.70m Radius	

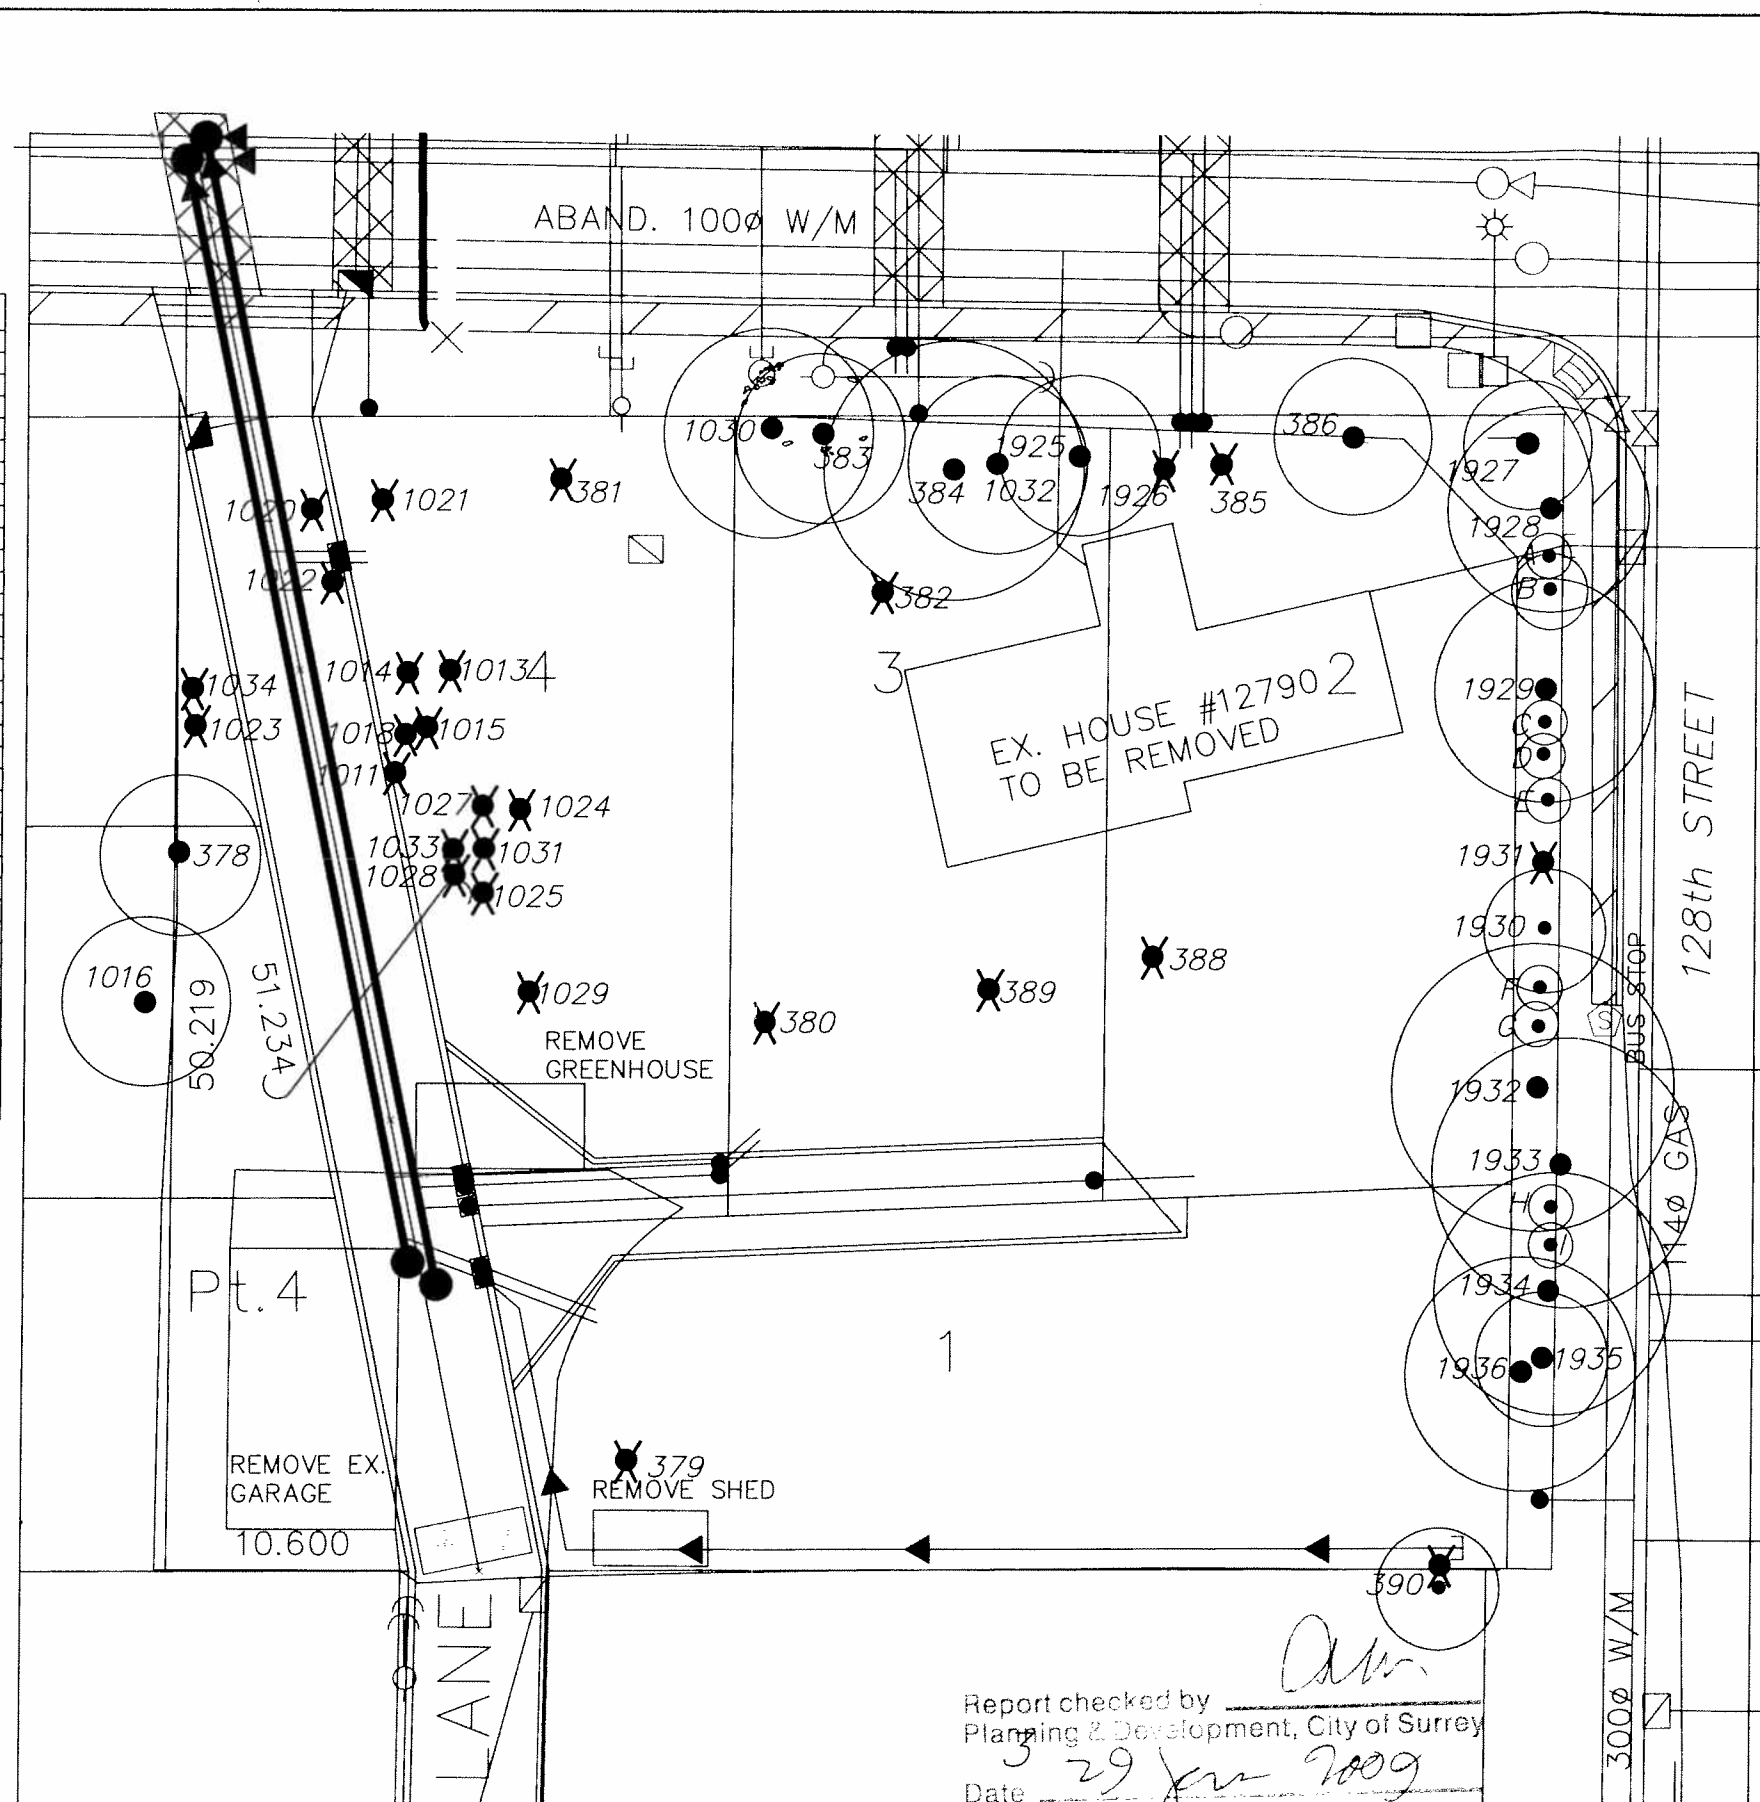

LEGEND

- = TREES TO BE RETAINED
- ✕ = TREES TO BE REMOVED
- = PROTECTION BARRIER

OCT/08	CITY OF SURREY REQUEST	5
SEPT/08	CITY OF SURREY REQUEST	4
AUG/08	NEW BY-LAW REQUIREMENTS	3
APR/08	REVISED LOT LAYOUT	2
NOV/07	REVISED LOT LAYOUT	1
DATE	REVISIONS	NO.

C. KAVOLINAS & ASSOCIATES INC.
BCSLA CSLA
2482 JOOUL COURT
ABBOTSFORD, B.C.
V3G 3E8
PHONE (604) 857-2376

CLIENT
MR. JOHN KAETHLER
ABBY DOWNS CONSTRUCTION LTD.
2607 - 139 STREET
SURREY, B.C.
V4P 2K3
PHONE (604) 541-6229

TITLE
PLAN VIEW
TREE LOCATION PLAN
TREE RETENTION PLAN
4 LOT SUBDIVISION
12790 - 60th AVENUE
SURREY, B.C.

SCALE	1:150	DATE	AUG/07
DRAFT		OWN	
ENG		OWN	
APPROV		AS BUILT	

Report checked by *Adm.*
Planning & Development, City of Surrey
Date *3 29 Jun 2009*

Acceptable Not Acceptable

PRINTED: JOB No. DRAWING No. L-1